



DEPARTMENT OF REGULATORY AND ECONOMIC RESOURCES (RER)
BOARD AND CODE ADMINISTRATION DIVISION
NOTICE OF ACCEPTANCE (NOA)

MIAMI-DADE COUNTY
PRODUCT CONTROL SECTION
11805 SW 26 Street, Room 208
T (786) 315-2590 F (786) 315-2599
www.miamidade.gov/economy

Regency Plus, Inc.
1024 Locust Gap Highway
Mount Carmel, PA 17851

SCOPE:

This NOA is being issued under the applicable rules and regulations governing the use of construction materials. The documentation submitted has been reviewed and accepted by Miami-Dade County RER-Product Control Section to be used in Miami-Dade County and other areas where allowed by the Authority Having Jurisdiction (AHJ).

This NOA shall not be valid after the expiration date stated below. The Miami-Dade County Product Control Section (In Miami-Dade County) and/ or the AHJ (in areas other than Miami-Dade County) reserve the right to have this product or material tested for quality assurance purposes. If this product or material fails to perform in the accepted manner, the manufacturer will incur the expense of such testing and the AHJ may immediately revoke, modify, or suspend the use of such product or material within their jurisdiction. RER reserves the right to revoke this acceptance, if it is determined by Miami-Dade County Product Control Section that this product or material fails to meet the requirements of the applicable building code.

This product is approved as described herein, and has been designed to comply with the Florida Building Code, including the High Velocity Hurricane Zone.

DESCRIPTION: Series "5305 Tilt" White PVC Double Hung Window – L.M.I.

APPROVAL DOCUMENT: Drawing No. RPLS0064, titled "Series 5305 Tilt Double Hung Impact Vinyl Window", sheets 1 through 8 of 8, dated 01/12/09, with revision H dated 09/24/15, prepared by PTC, LLC, signed and sealed by Robert J. Amoroso, P.E., bearing the Miami-Dade County Product Control Revision stamp with the Notice of Acceptance number and Expiration date by the Miami-Dade County Product Control Section.

MISSILE IMPACT RATING: Large and Small Missile Impact Resistant

LABELING: Each unit shall bear a permanent label with the manufacturer's name or logo, city, state, series, and following statement: "Miami-Dade County Product Control Approved", unless otherwise noted herein.

RENEWAL of this NOA shall be considered after a renewal application has been filed and there has been no change in the applicable building code negatively affecting the performance of this product.

TERMINATION of this NOA will occur after the expiration date or if there has been a revision or change in the materials, use, and/ or manufacture of the product or process. Misuse of this NOA as an endorsement of any product, for sales, advertising or any other purposes shall automatically terminate this NOA. Failure to comply with any section of this NOA shall be cause for termination and removal of NOA.

ADVERTISEMENT: The NOA number preceded by the words Miami-Dade County, Florida, and followed by the expiration date may be displayed in advertising literature. If any portion of the NOA is displayed, then it shall be done in its entirety.

INSPECTION: A copy of this entire NOA shall be provided to the user by the manufacturer or its distributors and shall be available for inspection at the job site at the request of the Building Official.

This NOA revises NOA No. 13-1007.10 and consists of this page 1 and evidence pages E-1 and E-2, as well as approval document mentioned above.

The submitted documentation was reviewed by Manuel Perez, P.E.



MP
9/29/15

NOA No. 15-0618.02
Expiration Date: May 06, 2019
Approval Date: October 01, 2015
Page 1

NOTICE OF ACCEPTANCE: EVIDENCE SUBMITTED

A. DRAWINGS

1. Manufacturer's die drawings and sections.
(Submitted under NOA No. 09-0122.05)
2. Drawing No. **RPLS0064**, titled "Series 5305 Tilt Double Hung Impact Vinyl Window", sheets 1 through 8 of 8, dated 01/12/09, with revision **H** dated 09/24/15, prepared by PTC, LLC, signed and sealed by Robert J. Amoruso, P.E.

B. TESTS

1. Test reports on: 1) Air Infiltration Test, per FBC, TAS 202-94
2) Uniform Static Air Pressure Test, Loading per FBC, TAS 202-94
3) Water Resistance Test, per FBC, TAS 202-94
4) Large Missile Impact Test per FBC, TAS 201-94
5) Cyclic Wind Pressure Loading per FBC, TAS 203-94
6) Forced Entry Test, per FBC 2411.3.2.1 (b) and TAS 202-94
along with marked-up drawings and installation diagram of series 5305 tilt double hung vinyl window, prepared by National Certified Testing Laboratories, Test Report No. **NCTL-110-11422-2**, dated 10/02/08, with revision dated 01/08/09, and addendum letter dated 03/12/09, all signed and sealed by Harold E. Rupp, P.E.
(Submitted under NOA No. 09-0122.05)

C. CALCULATIONS

1. Anchor verification calculations and structural analysis, complying with **FBC 5th Edition (2014)**, dated 06/01/15 with revision dated 09/01/15, prepared by PTC, LLC, signed and sealed by Robert J. Amoruso, P.E.
2. **Glazing complies with ASTM E1300-04e01**

D. QUALITY ASSURANCE

1. Miami-Dade Department of Regulatory and Economic Resources (RER).

E. MATERIAL CERTIFICATIONS

1. Notice of Acceptance No. **14-0916.10** issued to **Kuraray America, Inc.** for their "**Kuraray Butacite® PVB Glass Interlayer**" dated 04/25/15, expiring on 12/11/16.
2. Notice of Acceptance No. **12-1120.02**, issued to **Royal Window and Door Profiles, Plant 13**, for their **White Rigid PVC Exterior Extrusions**, approved on 02/28/13, expiring on 02/28/18.


Manuel Perez, P.E.
Product Control Examiner
NOA No. 15-0618.02

Expiration Date: May 06, 2019
Approval Date: October 01, 2015

Regency Plus, Inc.

NOTICE OF ACCEPTANCE: EVIDENCE SUBMITTED

F. STATEMENTS

1. Statement letter of conformance to, of complying with **FBC 5th Edition (2014)** and of no financial interest, dated 06/01/15, prepared by PTC, LLC, signed and sealed by Robert J. Amoruso, P.E.
2. Laboratory compliance letter in the Test Report No. **NCTL-110-11422-2**, issued by National Certified Testing Laboratories, dated 10/02/08, with revision dated 01/08/09, signed and sealed by Harold E. Rupp, P.E.
(Submitted under NOA No. 09-0122.05)

G. OTHERS

1. Notice of Acceptance No. **13-1007.10**, issued to Regency Plus, Inc. for their Series "5305 Tilt" White PVC Double Hung Window - L.M.I., approved on 05/06/13 and expiring on 05/06/19.



Manuel Pérez, P.E.
Product Control Examiner
NOA No. 15-0618.02

Expiration Date: May 06, 2019
Approval Date: October 01, 2015

REGENCY PLUS

SERIES 5305 TILT DOUBLE HUNG IMPACT VINYL WINDOW

INSTALLATION ANCHORAGE DETAILS

GENERAL NOTES:

1. THE PRODUCT ANCHORAGE SHOWN HEREIN IS DESIGNED TO COMPLY WITH 5TH EDITION (2014) FLORIDA BUILDING CODE (FBC) - BUILDING AND RESIDENTIAL VOLUMES INCLUDING THE HIGH VELOCITY HURRICANE ZONE (HVHZ) AT THE DESIGN PRESSURE STATED HEREIN.
2. THE PRODUCT DETAILS CONTAINED HEREIN ARE BASED UPON SIGNED AND SEALED TEST REPORT # NCTL-110-11422-2 DATED 12/01/08, ADDENDUM DATED 11/05/08 AND ADDENDUM II DATED 03/10/09 AND ASSOCIATED LABORATORY STAMPED DRAWINGS AND WERE TESTED IN ACCORDANCE WITH HIGH VELOCITY HURRICANE ZONE TESTING PROTOCOLS TAS-201, TAS-202 AND TAS-203.
3. THE PRODUCT HAS BEEN EVALUATED FOR CONFORMANCE TO THE STANDARDS LISTED IN THE 5TH EDITION (2014) FLORIDA BUILDING CODE (FBC) - BUILDING AND RESIDENTIAL VOLUMES AND IS IN COMPLIANCE WITH SAID STANDARDS INCLUDING HIGH VELOCITY HURRICANE ZONE (HVHZ) REQUIREMENTS.
4. ADEQUACY OF THE EXISTING STRUCTURAL CONCRETE MASONRY AND 2X FRAMING AS A MAIN WIND FORCE RESISTING SYSTEM CAPABLE OF WITHSTANDING AND TRANSFERRING APPLIED PRODUCT LOADS TO THE STRUCTURE IS THE RESPONSIBILITY OF THE ENGINEER OR ARCHITECT OF RECORD AND TO BE REVIEWED BY AGENCY HAVING JURISDICTION (AHJ).
5. 1X AND 2X BUCKS (WHEN USED) SHALL BE DESIGNED AND ANCHORED TO PROPERLY TRANSFER ALL LOADS TO THE STRUCTURE. BUCK DESIGN AND INSTALLATION IS THE RESPONSIBILITY OF THE ENGINEER OR ARCHITECT OF RECORD AND TO BE REVIEWED BY AHJ.
6. THE INSTALLATION DETAILS DESCRIBED HEREIN ARE GENERIC AND MAY NOT REFLECT ACTUAL CONDITIONS FOR A SPECIFIC SITE. IF CONDITIONS CAUSE INSTALLATION TO DEVIATE FROM THE REQUIREMENTS DETAILED HEREIN, THEN THE BUILDING MAY ELECT ONE OF THE FOLLOWING OPTIONS:

- A. OUTSIDE HVHZ: REQUIRE THAT A LICENSED ENGINEER OR ARCHITECT PREPARE AND SUBMIT SITE SPECIFIC DOCUMENTS FOR USE WITH THIS DOCUMENT.
 - B. INSIDE HVHZ REQUIRE THAT A ONE-TIME SITE SPECIFIC APPROVAL BE APPLIED FOR AND OBTAINED FROM THE MIAMI-DADE COUNTY PRODUCT CONTROL.
7. MATERIALS:
 - 7.1 WINDOW FRAME MATERIAL: ROYAL WINDOW & DOOR PROFILES. PLANT 13 RIGID VINYL PVC PER MIAMI-DADE NOTICE OF ACCEPTANCE (NOA) NO. 12-1120.02.
 - 7.2 GLAZING INTERLAYER KURARAY AMERICA, INC. BUTACITE INTERLAYER PER MIAMI-DADE NOTICE OF ACCEPTANCE (NOA) NO. 14-0916.10.
 8. NOT USED.
 9. GLASS MEETS THE REQUIREMENTS OF ASTM E1300-04e1. SEE SHEET 6 FOR GLAZING DETAIL.
 10. DESIGNATION "X" STANDS FOR THE FOLLOWING:
X: OPERABLE PANEL
 11. A 1/3 INCREASE IN ALLOWABLE STRESS FOR WIND LOADS WAS NOT USED IN THE DESIGN OF THE PRODUCT(S) SHOWN HEREIN. WIND LOAD DURATION FACTOR ($C_d = 1.6$) HAS BEEN USED FOR WOOD ANCHOR DESIGN WHERE WOOD-ONLY FAILURE GOVERNS. FOR OTHER MATERIALS, APPROPRIATE SAFETY FACTORS PER THE APPLICABLE DESIGN STANDARD ARE USED.
 12. IN AREAS WHERE WIND-BORNE DEBRIS PROTECTION REQUIREMENTS EXIST, USE OF AN APPROVED IMPACT PROTECTIVE SYSTEM IS NOT REQUIRED.

INSTALLATION NOTES:

1. ONE (1) INSTALLATION ANCHOR IS REQUIRED AT EACH ANCHOR LOCATION SHOWN.
2. THE NUMBER OF INSTALLATION ANCHORS DEPICTED IS THE MINIMUM NUMBER OF ANCHORS TO BE USED FOR PRODUCT INSTALLATION.
3. SHIM AS REQUIRED AT EACH INSTALLATION ANCHOR WITH LOAD BEARING SHIM(S). MAXIMUM ALLOWABLE SHIM SIZE IS 1/4 INCH. SHIM WHERE SPACE OF 1/16 INCH OR GREATER OCCURS. SHIM(S) SHALL BE CONSTRUCTED OF HIGH DENSITY PLASTIC OR BETTER.
4. FOR INSTALLATION INTO WOOD FRAMING, USE #12 WOOD SCREWS OF SUFFICIENT LENGTH TO ACHIEVE 1 1/2 INCH MINIMUM EMBEDMENT. MINIMUM EDGE DISTANCE IS 7/8 INCHES.
5. FOR INSTALLATION THROUGH 1X BUCK TO CONCRETE / MASONRY, OR DIRECTLY INTO CONCRETE / MASONRY, USE 1/4 INCH ITW ADVANCED THREADFORM TAPCONS OF SUFFICIENT LENGTH TO ACHIEVE THE FOLLOWING:
 - 5.1. CONCRETE SUBSTRATE
 - 5.1.1. 1 1/2 INCH MINIMUM EMBEDMENT
 - 5.1.2. 1-1/2 INCH MINIMUM EDGE DISTANCE
 - 5.2. MASONRY SUBSTRATE
 - 5.2.1. 1 INCH MINIMUM EMBEDMENT
 - 5.2.2. 2 INCH MINIMUM EDGE DISTANCE
6. FOR PARTING STOP INSTALLATION USE #8 WOOD SCREWS.
7. MINIMUM EMBEDMENT AND EDGE DISTANCE EXCLUDE WALL FINISHES, INCLUDING BUT NOT LIMITED TO STUCCO, FOAM, BRICK VENEER AND SIDING.
8. INSTALLATION ANCHORS AND ASSOCIATED HARDWARE MUST BE MADE OF CORROSION RESISTANT MATERIAL OR HAVE A CORROSION RESISTANT COATING.
9. FOR CONCRETE BLOCK, DO NOT INSTALL INSTALLATION ANCHORS INTO MORTAR JOINTS. EDGE DISTANCE IS MEASURED FROM FREE EDGE OF BLOCK OR EDGE OF MORTAR JOINT INTO FACE SHELL OF BLOCK.
10. INSTALLATION ANCHORS SHALL BE INSTALLED IN ACCORDANCE WITH ANCHOR MANUFACTURER'S INSTALLATION INSTRUCTIONS AND ANCHORS SHALL NOT BE USED IN SUBSTRATES WITH STRENGTHS LESS THAN THE MINIMUM STRENGTH SPECIFIED BY THE ANCHOR MANUFACTURER.
11. INSTALLATION ANCHOR CAPACITIES FOR PRODUCTS HEREIN ARE BASED ON SUBSTRATE MATERIALS WITH THE FOLLOWING PROPERTIES:
 - A. WOOD - PRESSURE TREATED (PT) SOUTHERN YELLOW PINE. MINIMUM SPECIFIC GRAVITY OF 0.55 LUMBER MUST COMPLY WITH 5TH EDITION FBC/FRC AS RELATED TO WOOD PROTECTION.
 - B. CONCRETE - MINIMUM COMPRESSIVE STRENGTH OF 2500 psi AND COMPLIES WITH ACI 301.
 - C. MASONRY - STRENGTH CONFORMS TO ASTM C-90, MEDIUM WEIGHT WITH DENSITY >117 PCF.


TABLE OF CONTENTS		
SHEET	REV.	SHEET DESCRIPTION
1	D	GENERAL NOTES, INSTALLATION NOTES & D.P. CHART
2	D	ELEVATION & ANCHOR LAYOUT
3	D	ELEVATION & ANCHOR LAYOUT
4	D	VERTICAL SECTIONS
5	D	VERTICAL SECTIONS
6	D	HORIZONTAL SECTIONS & GLAZING DETAIL
7	D	BILL OF MATERIALS AND COMPONENTS
8	D	COMPONENTS & CORNER DETAIL

DESIGN PRESSURE RATING (PSF)	IMPACT RATING
±55.0	LARGE MISSILE IMPACT


PROJECT #414-0418				
H	INCORPORATE M.D. RFI COMMENTS	9/24/5	RJA	
G	INCORPORATE M.D. RFI COMMENTS	9/1/15	RJA	
F	UPDATED TO 5TH ED. (2014) FBC	6/1/15	JBH	
REV	DESCRIPTION	DATE	BY	

REGENCY PLUS				
2000 LOCUST GAP HIGHWAY				
MT. CARMEL, PA 17851				
TITLE: SERIES 5305 TILT DOUBLE HUNG IMPACT VINYL WINDOW				
GENERAL AND INSTALLATION NOTES				
DRAWN BY:	BB	DATE:	1/12/09	
SCALE:	N.T.S.	DRAWING NO.:	RPLS0064	
REV:	H	SHEET:	1 OF 8	
PTC Product Design Group, LLC				
PO Box 520775, Longwood, FL 32752-0775				
321-690-1788 info@ptc-corp.com				
FBPE Cert. of Auth. No. 25835				


Robert J. Amoroso, P.E.
Florida P.E. No. 49752

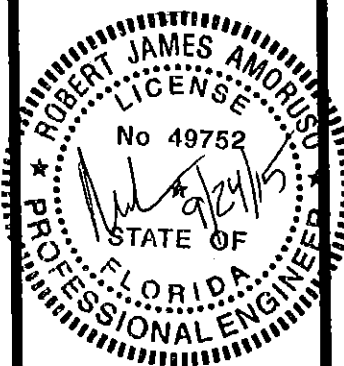

PRODUCT REVISED
as complying with the Florida
Building Code
Acceptance No. 15-0618.02
Expiration Date May 6, 2019
By *Manuel Saez*
Miami Dade Product Control

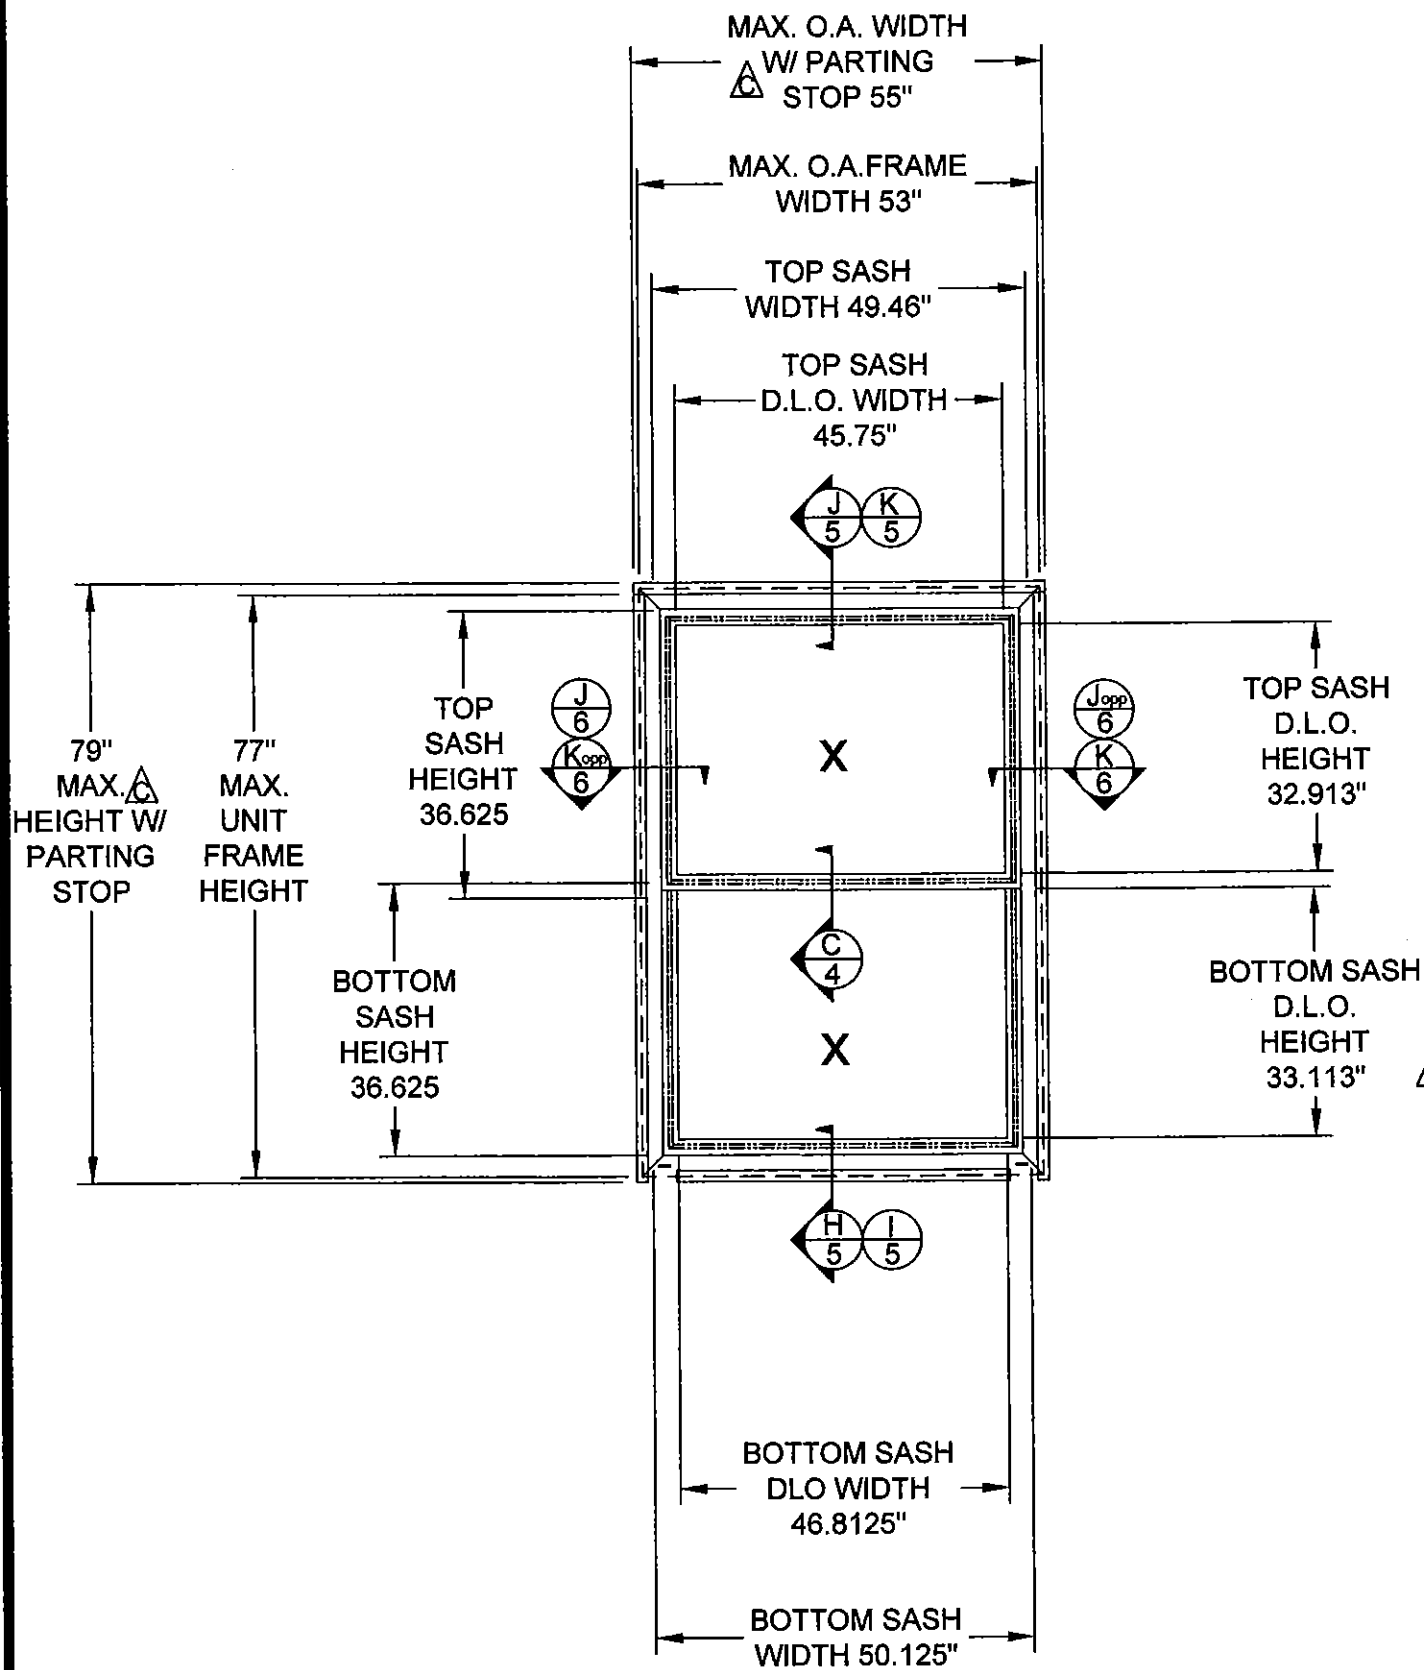

ELEVATION
EXTERIOR VIEW
W/ PARTING STOPS

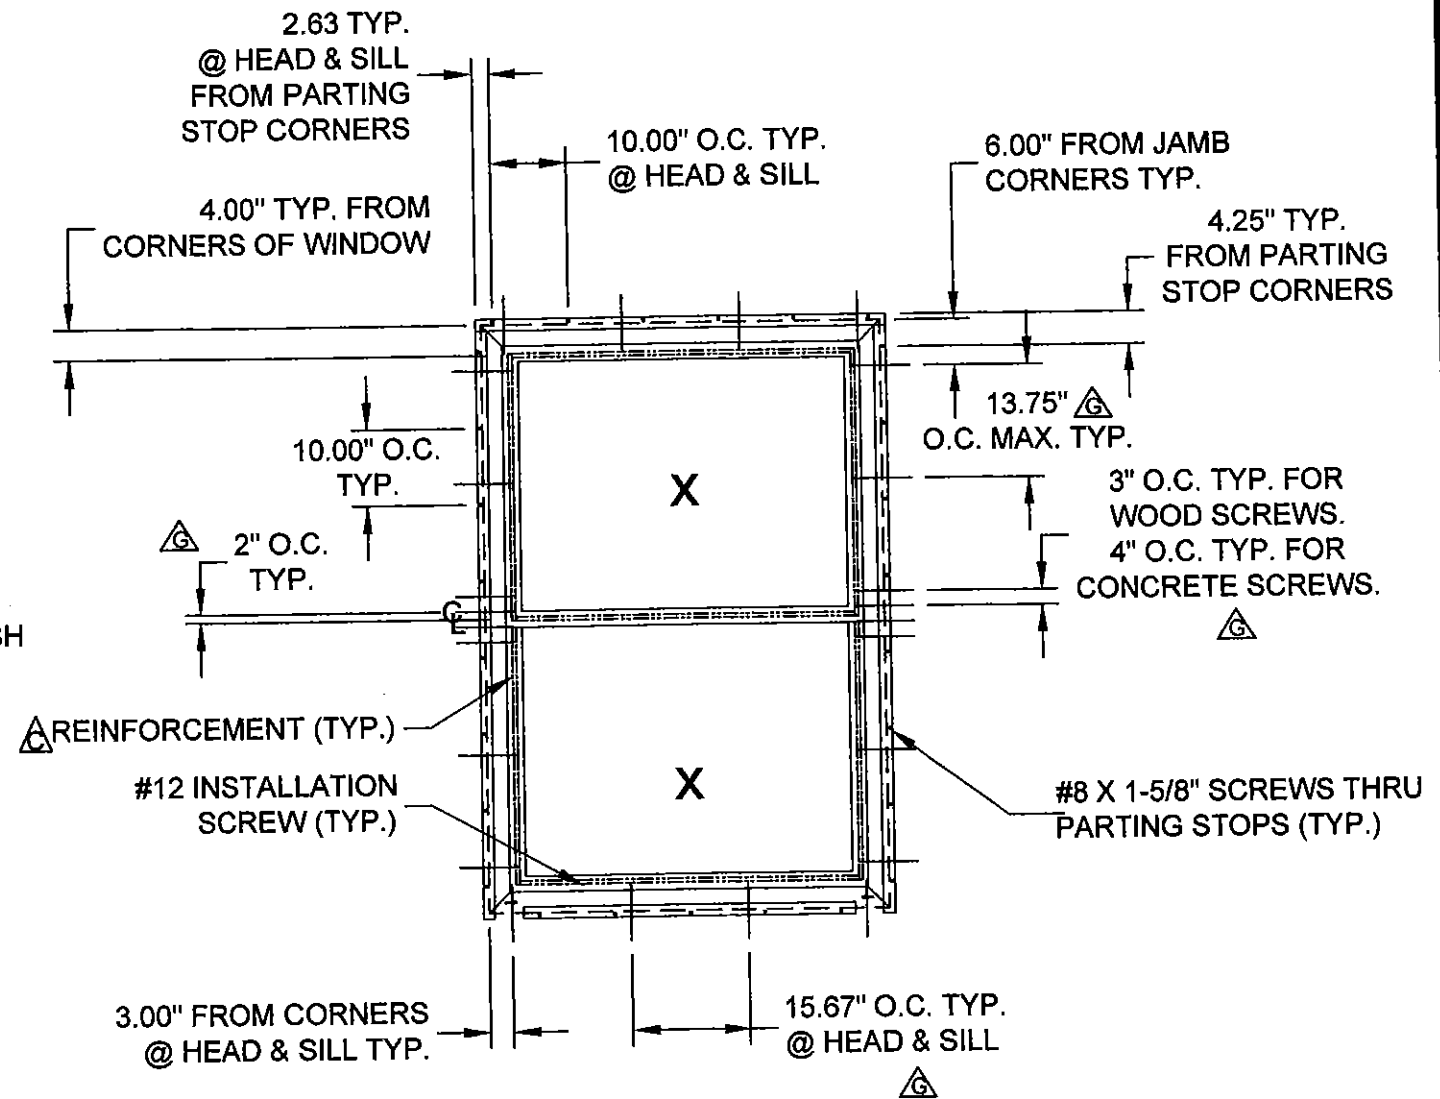


ANCHOR LAYOUT
EXTERIOR VIEW
W/ PARTING STOPS


PROJECT #414-0418				
INCORPORATE M.D. RFI COMMENTS	9/24/5	RJA		
INCORPORATE M.D. RFI COMMENTS	9/1/15	RJA		
UPDATED TO 5TH ED. (2014) FBC	6/1/15	JBH		
DESCRIPTION	DATE	BY		
REV				

REGENCY PLUS 2000 LOCUST GAP HIGHWAY MT. CARMEL, PA 17851				
TITLE: SERIES 5305 TILT DOUBLE HUNG IMPACT VINYL WINDOW ELEVATION & ANCHOR LAYOUT				
DRAWN BY: BB	DATE: 1/12/09	DRAWING NO: RPLS0064	SHEET: 2 OF 8	
SCALE:				
REV: H				
PTC PTC Product Design Group, LLC PO Box 520775, Longwood, FL 32752-0775 321-690-1788 info@ptc-corp.com FBPE Cert. of Auth. No. 25935				


Robert J. Amoroso, P.E.
Florida P.E. No. 49752

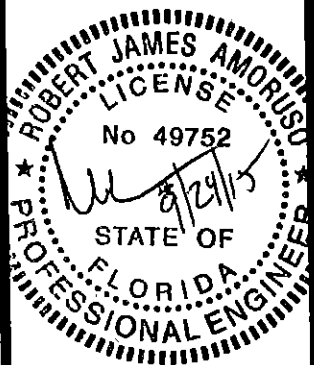

PRODUCT REVISED
as complying with the Florida
Building Code
Acceptance No. 15-061802
Expiration Date May 6, 2019
By *Mamuel Jara*
Miami Dade Product Control

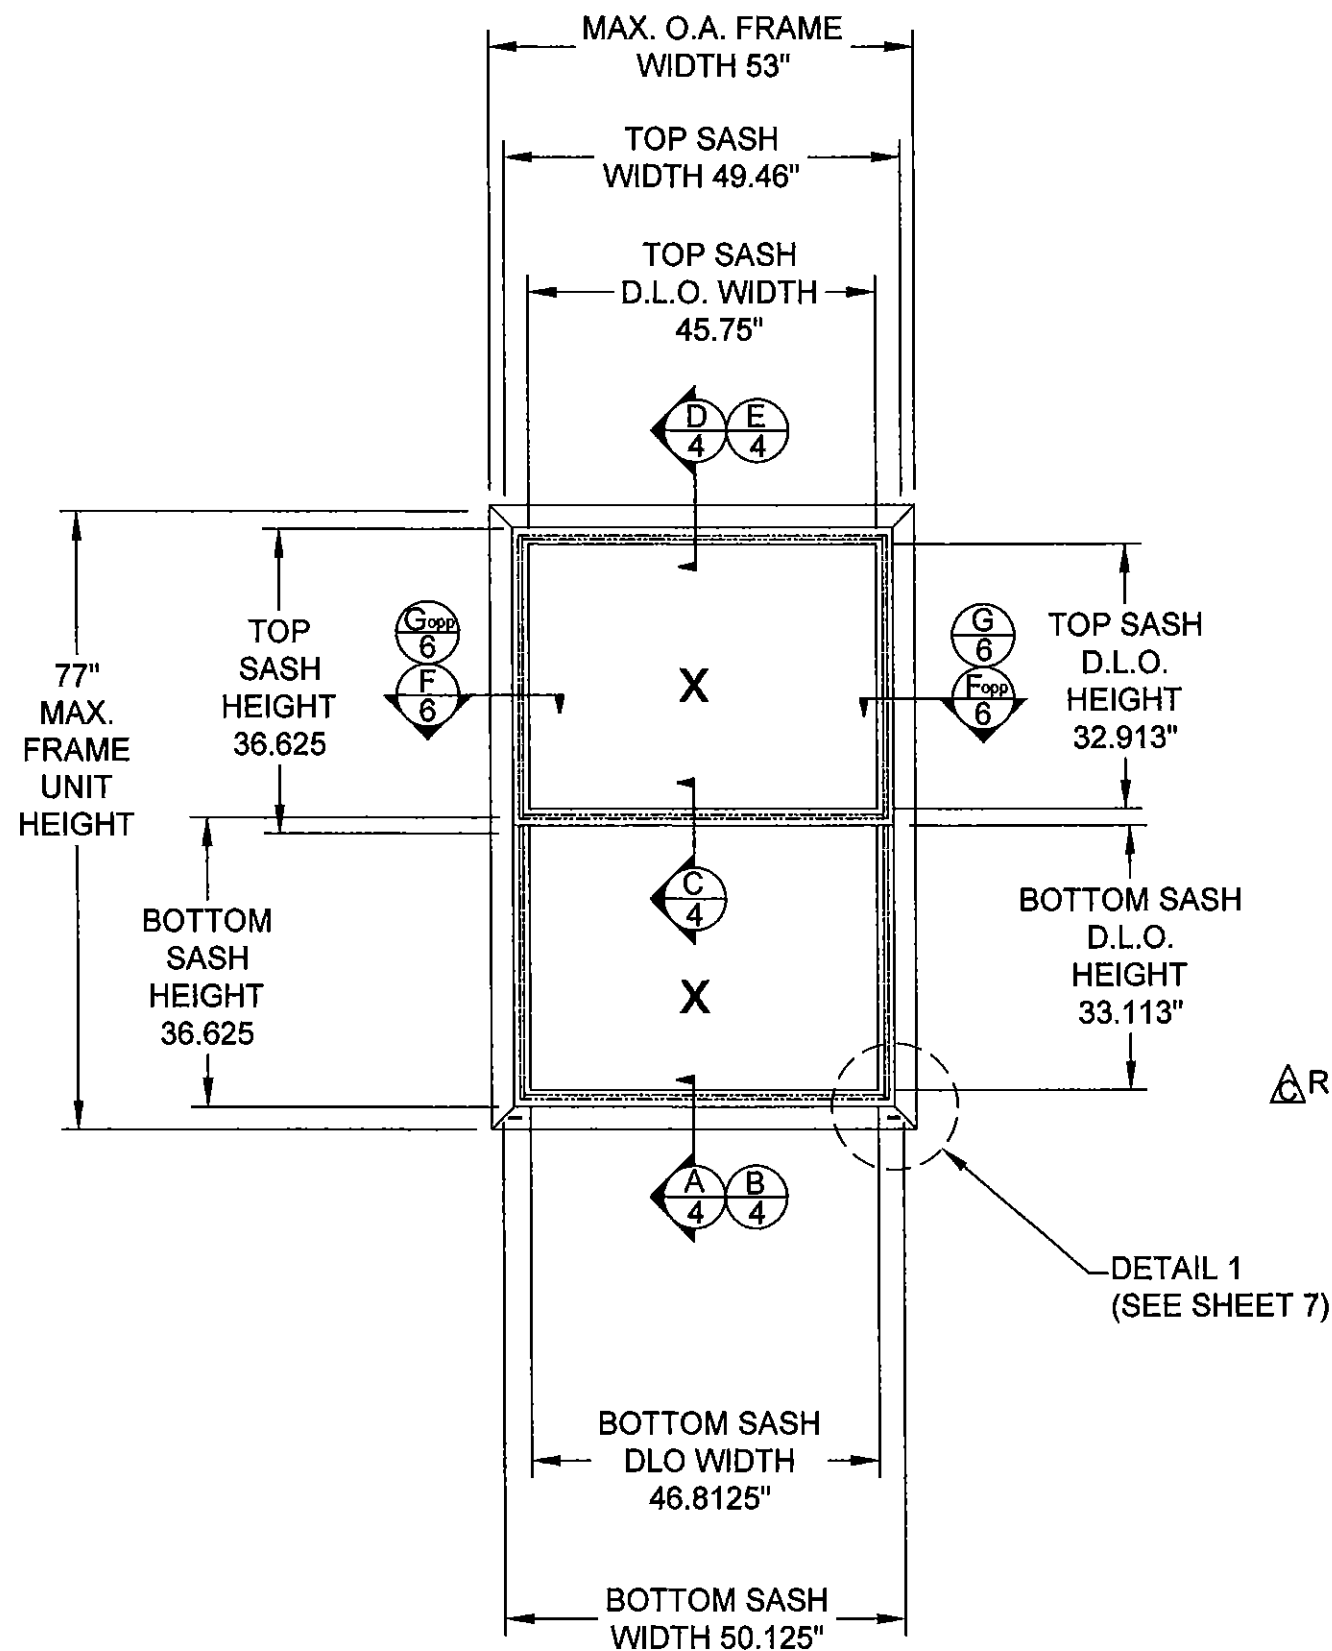

ELEVATION
EXTERIOR VIEW
W/O PARTING STOPS

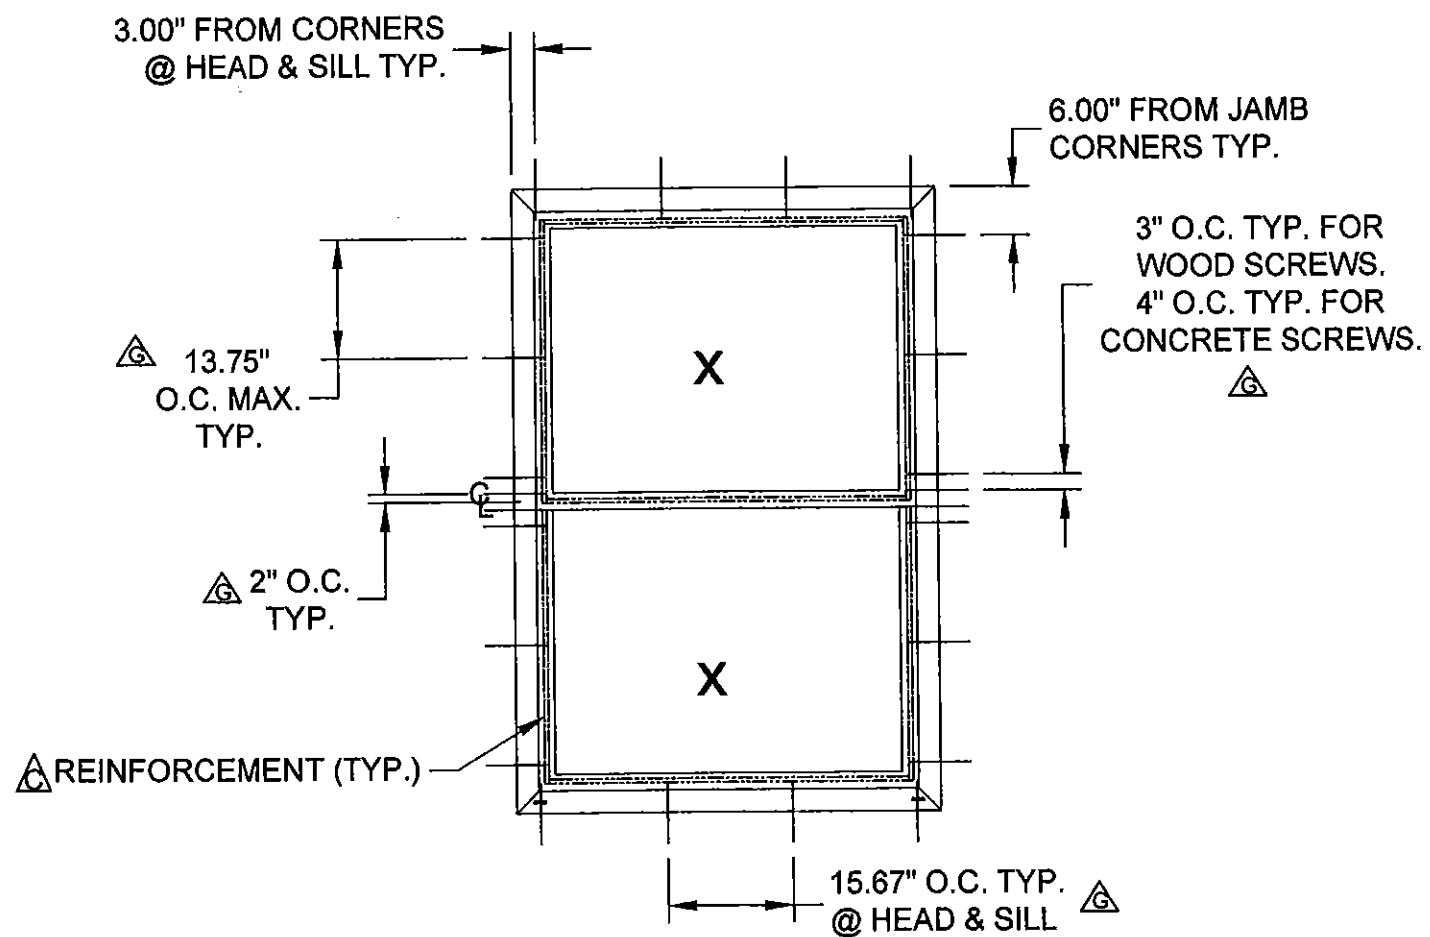


ANCHOR LAYOUT
EXTERIOR VIEW
W/O PARTING STOPS



PROJECT #414-0418	RJA	9/24/5	INCORPORATE M.D. RFI COMMENTS	RJA	9/1/15	INCORPORATE M.D. RFI COMMENTS	JBH	6/1/15	DATE	BY
	H			G			F		DESCRIPTION	REV

REGENCY PLUS 2000 LOCUST GAP HIGHWAY MT. CARMEL, PA 17851	DATE: 1/12/09	DRAWING NO: RPLS0064	SHEET: 3 OF 8
TITLE: SERIES 5305 TILT DOUBLE HUNG IMPACT VINYL WINDOW ELEVATION & ANCHOR LAYOUT	DRAWN BY: BB	SCALE: RPLS0064	REV: H
PTC Product Design Group, LLC PO Box 520775, Longwood, FL 32752-0775 321-690-1788 info@ptc-corp.com FBPE Cert. of Auth. No. 25935			

Robert J. Amoroso, P.E.
Florida P.E. No. 49752

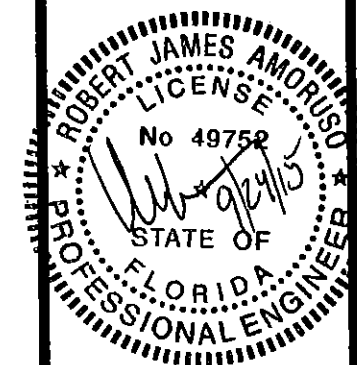

PRODUCT REVISED
as complying with the Florida
Building Code
Acceptance No 15-0618.02
Expiration Date May 6, 2019
By *Mamuel Perez*
Miami Dade Product Control

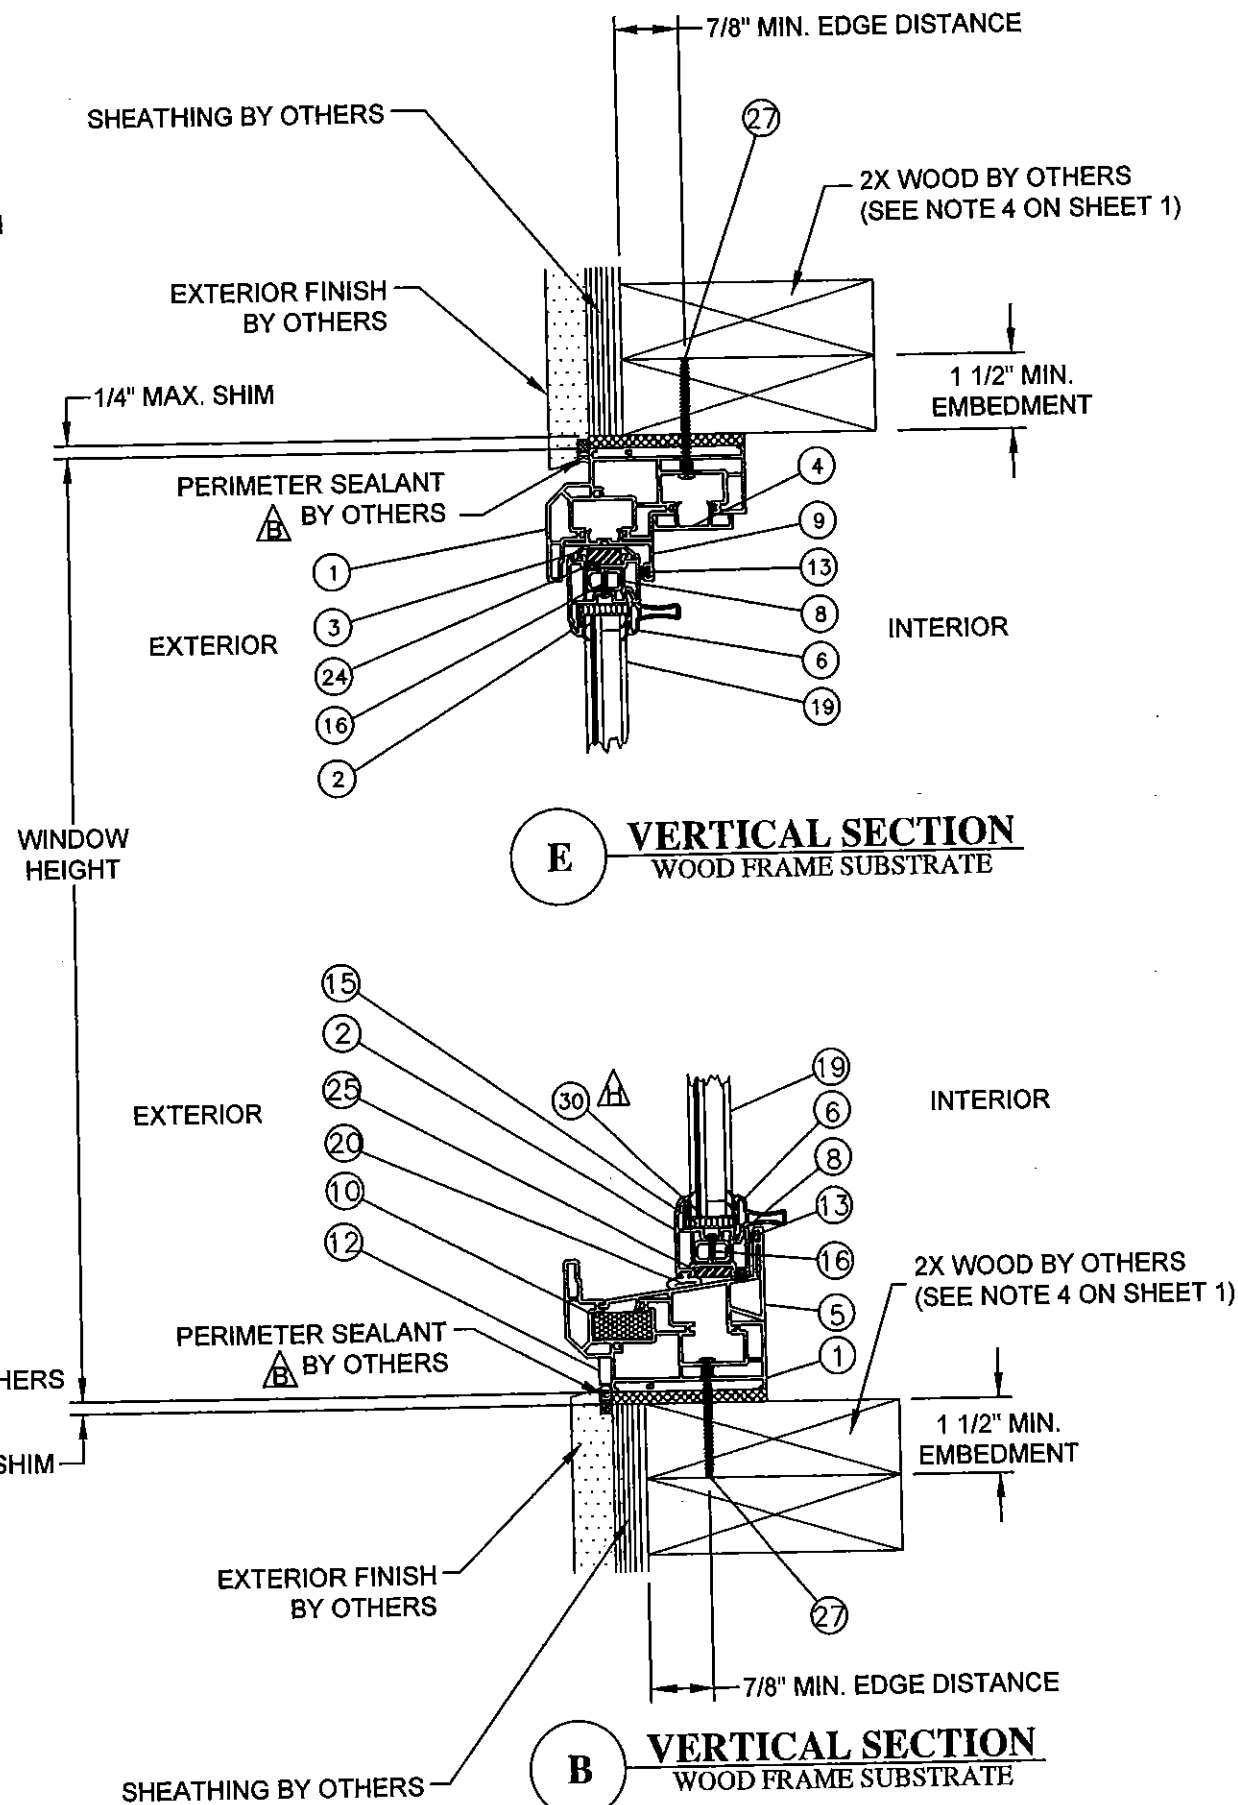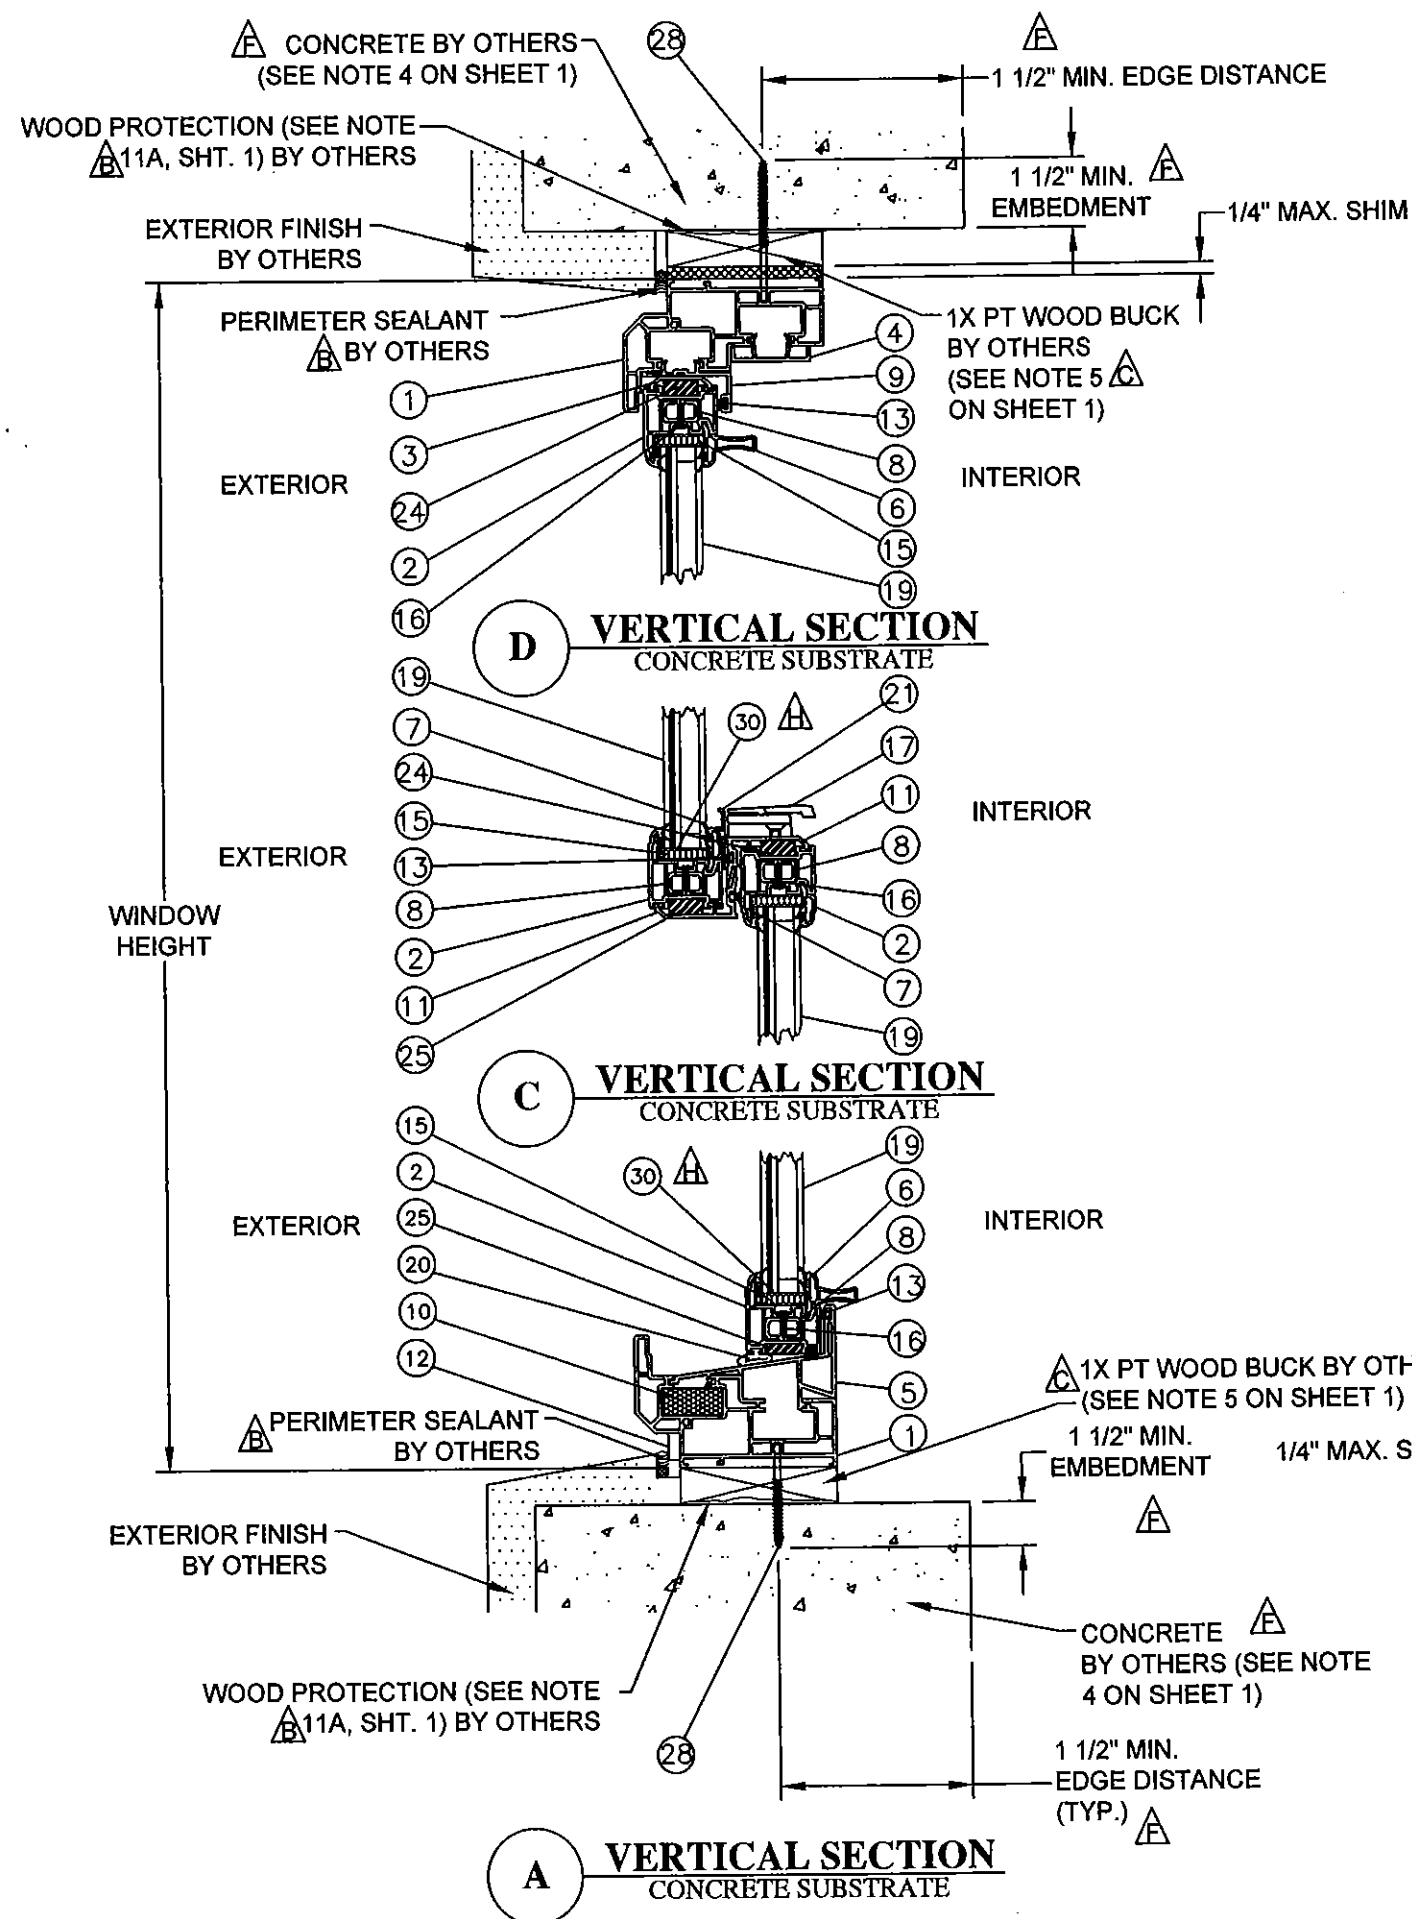


PROJECT #414-0418


INCORPORATE M.D. RFI COMMENTS	INCORPORATE M.D. RFI COMMENTS	UPDATED TO 5TH ED. (2014) FBC	DESCRIPTION	DATE	BY
H	G	F	REV		
9/24/5	9/1/15	6/1/15			
RJA	RJA	JBH			

REGENCY PLUS	DATE: 1/12/09	DRAWING NO: RPLS0064	SHEET: 4 OF 8
2000 LOCUST GAP HIGHWAY	MT. CARMEL, PA 17851	SCALE: H	REV: H
TITLE: SERIES 5305 TILT DOUBLE HUNG IMPACT VINYL WINDOW VERTICAL SECTIONS			
PTC Product Design Group, LLC PO Box 520775, Longwood, FL 32752-0775 321-680-1788 info@ptc-corp.com FBPE Cert. of Auth. No. 25935			



Robert J. Amoroso, P.E.
Florida P.E. No. 49752

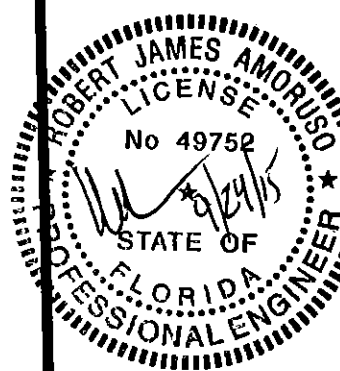


PRODUCT REVISED
as complying with the Florida
Building Code
Acceptance No 15-0618.02
Expiration Date May 6, 2019
By *Manuel Serra*
Miami/Dade Product Control

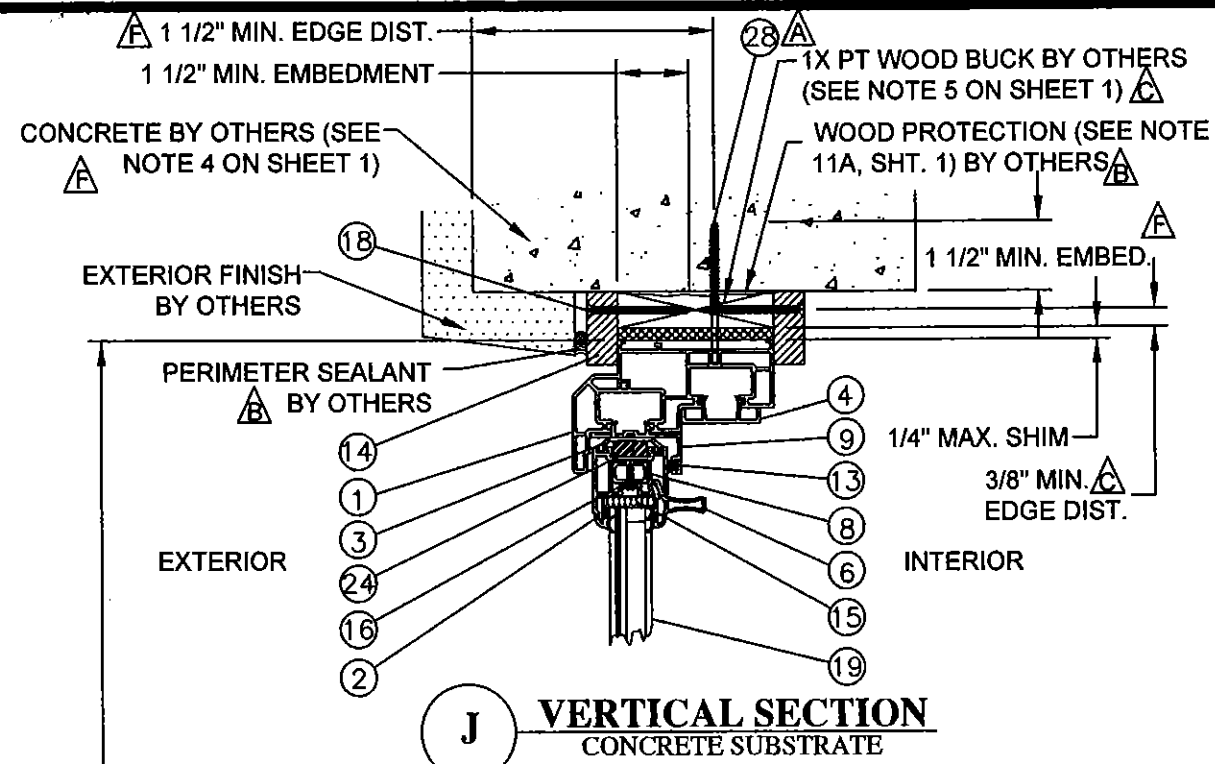

WINDOW HEIGHT

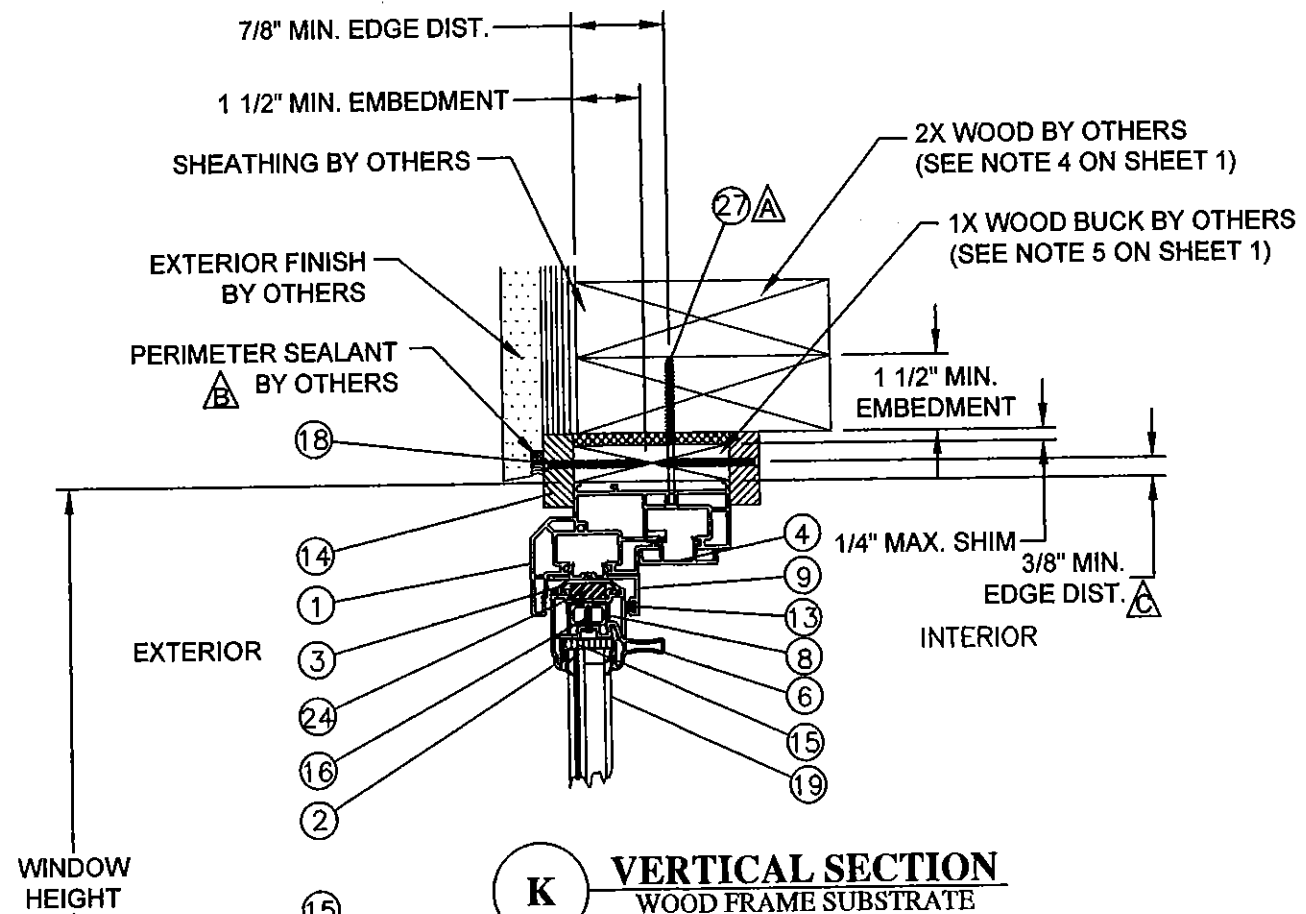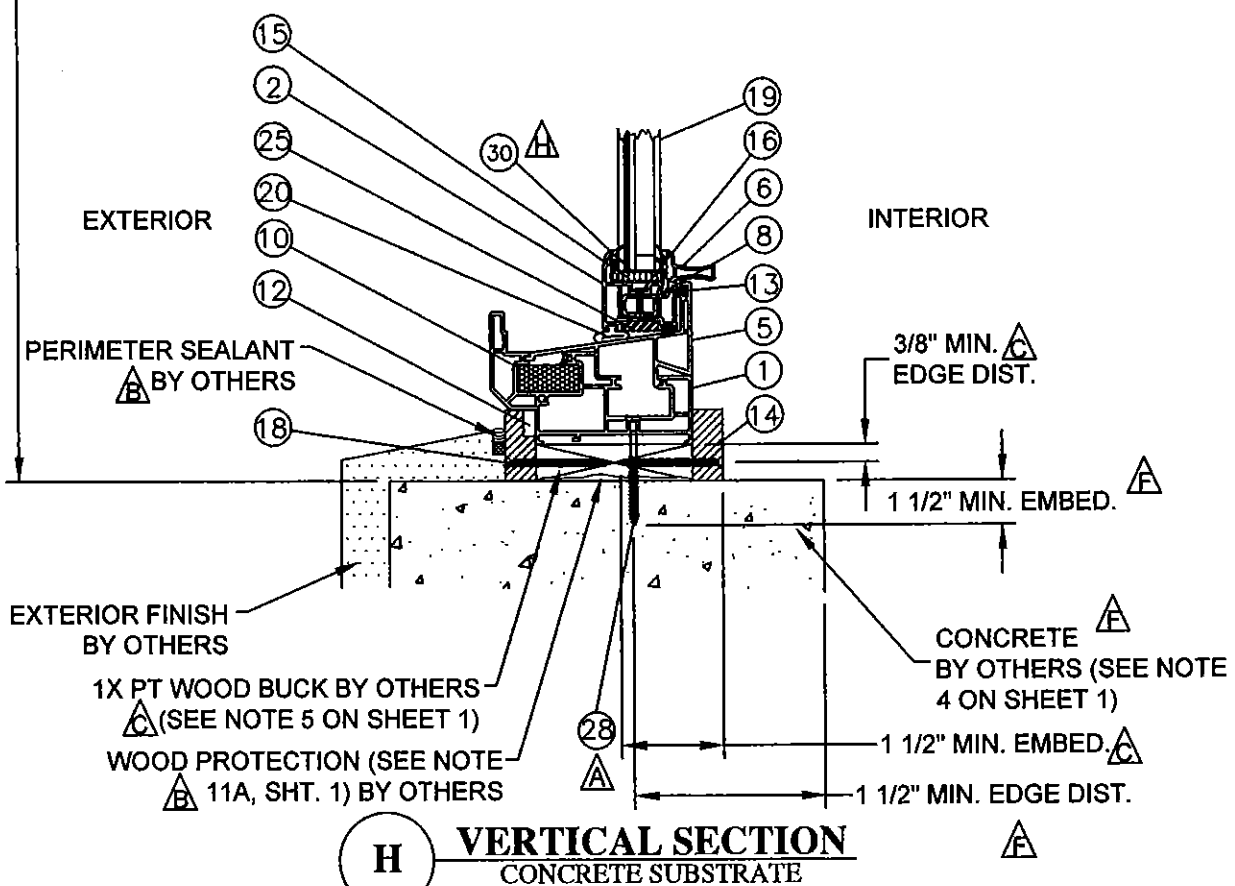


WINDOW HEIGHT

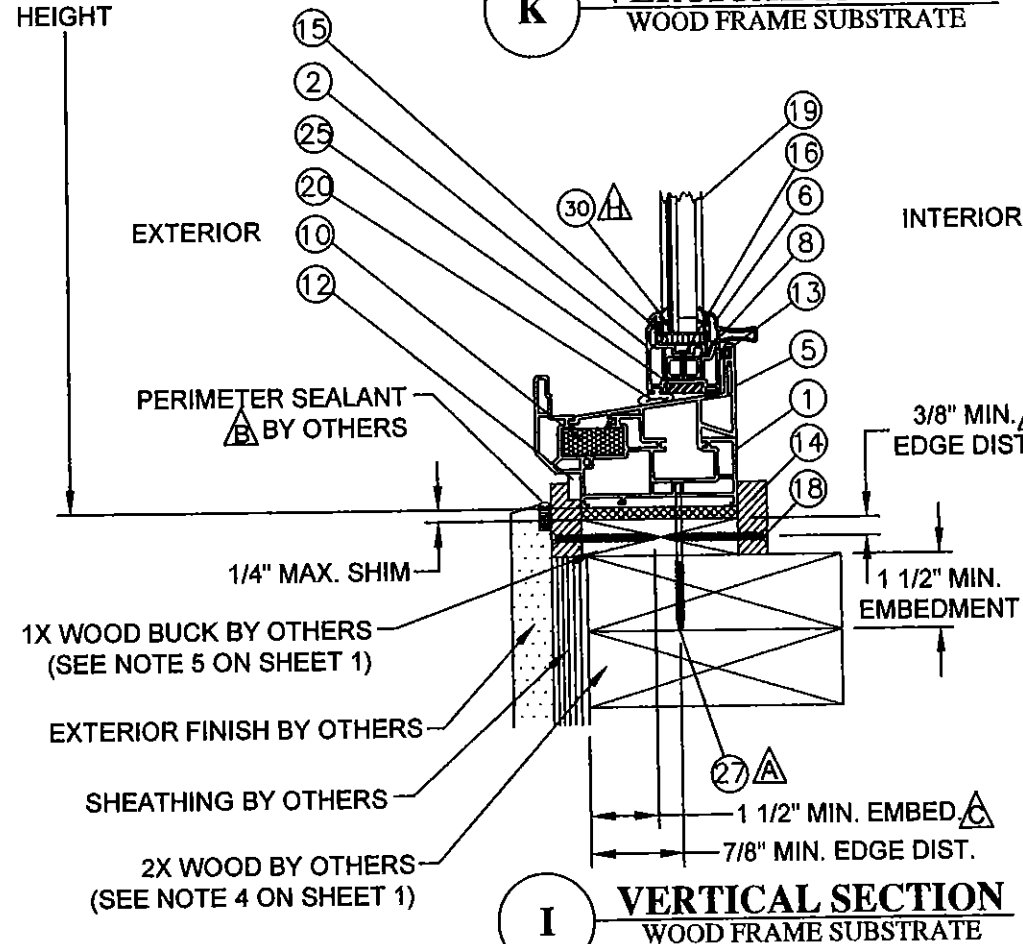


PROJECT #414-0418	RJA	RJA	JBH	BY
INCORPORATE M.D. RFI COMMENTS	9/24/5	9/1/15	6/1/15	DATE
INCORPORATE M.D. RFI COMMENTS	H	G	F	REV
UPDATED TO 5TH ED. (2014) FBC				DESCRIPTION

REGENCY PLUS	DATE: 1/12/09	SCALE: RPLS0064	REV: 5 OF 8
2000 LOCUST GAP HIGHWAY	DRAWN BY: BB	PTC Product Design Group, LLC	PO Box 520775, Longwood, FL 32752-0775
MT. CARMEL, PA 17851	SCALE: RPLS0064	321-690-1788 info@ptc-corp.com	FBPE Cert. of Auth. No. 25935
TITLE SERIES 5305 TILT DOUBLE HUNG IMPACT VINYL WINDOW			
VERTICAL SECTIONS			


Robert J. Amoroso, P.E.
Florida P.E. No. 49752

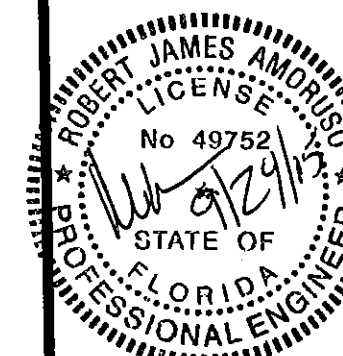



PRODUCT REVISED
as complying with the Florida
Building Code
Acceptance No. 15-0618.07
Expiration Date May 6, 2019
By *Wm. J. Amoroso*
Miami Dade Product Control

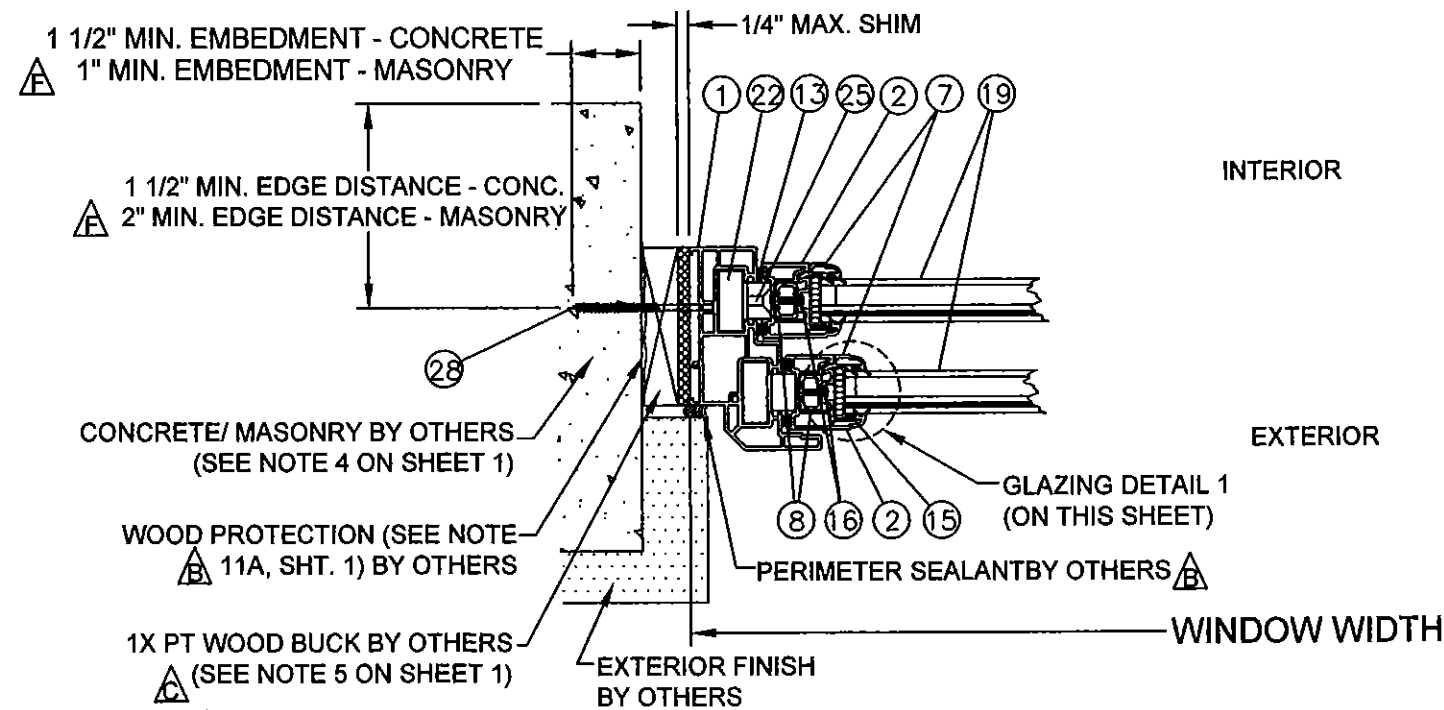


F HORIZONTAL SECTION
CONCRETE / MASONRY SUBSTRATE

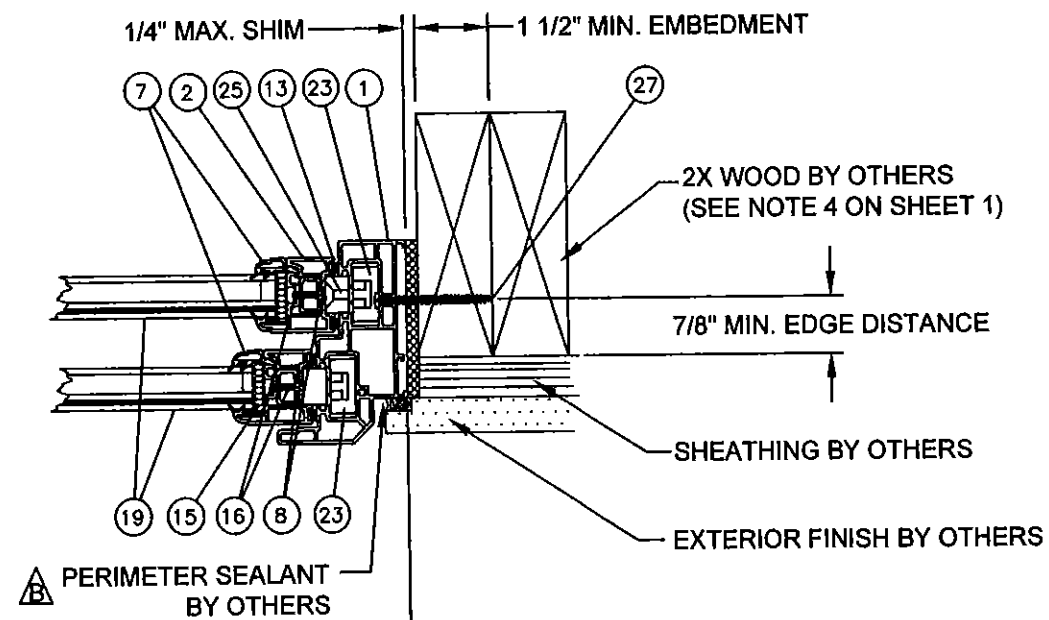

G HORIZONTAL SECTION
WOOD FRAME SUBSTRATE

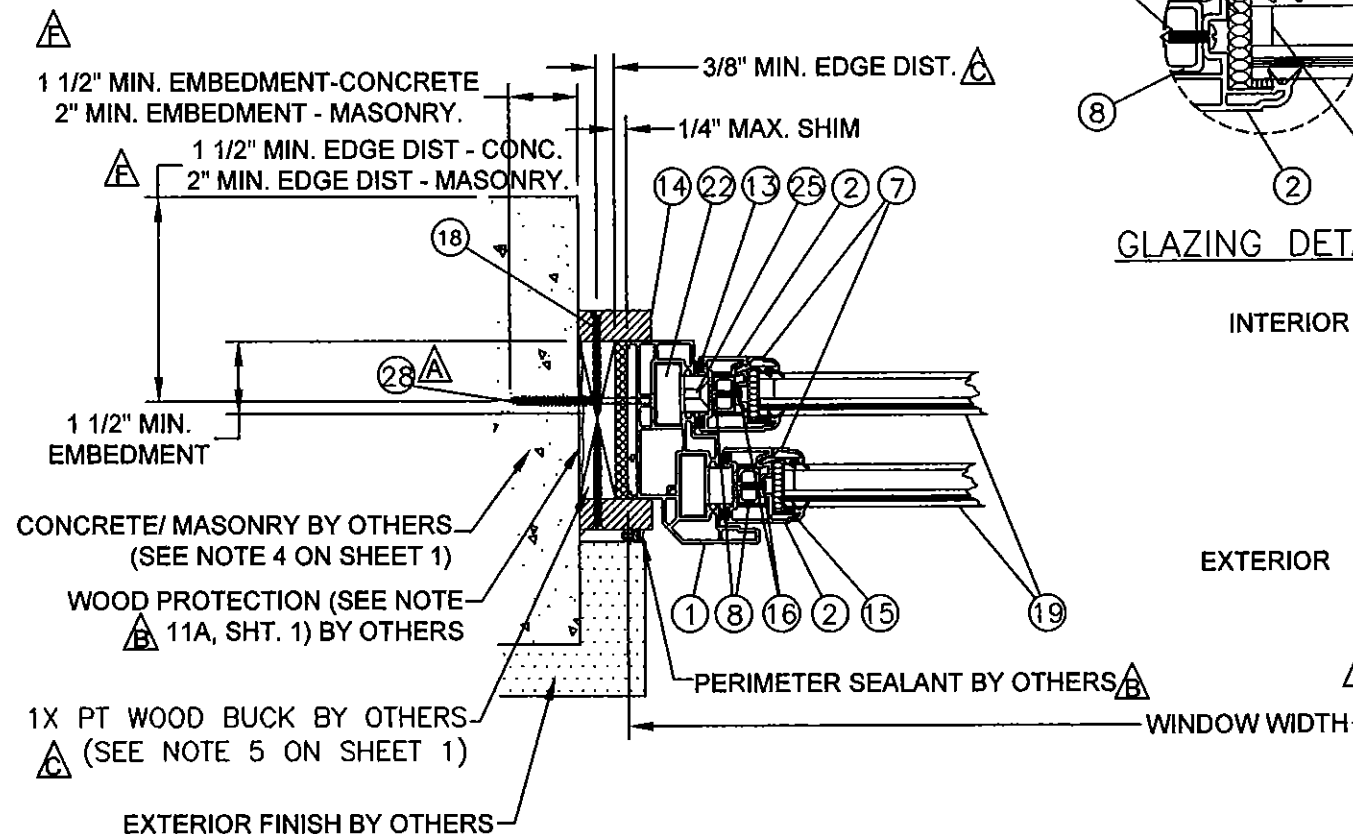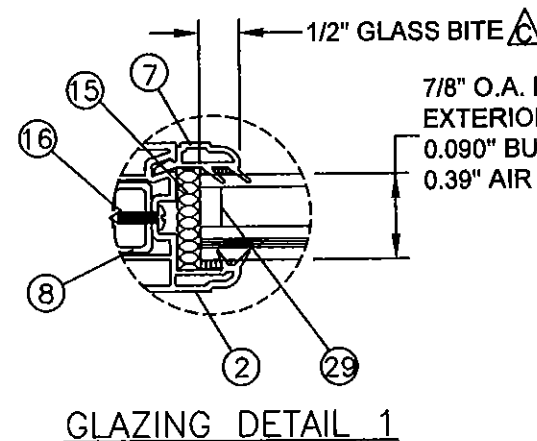

J HORIZONTAL SECTION
CONCRETE / MASONRY SUBSTRATE

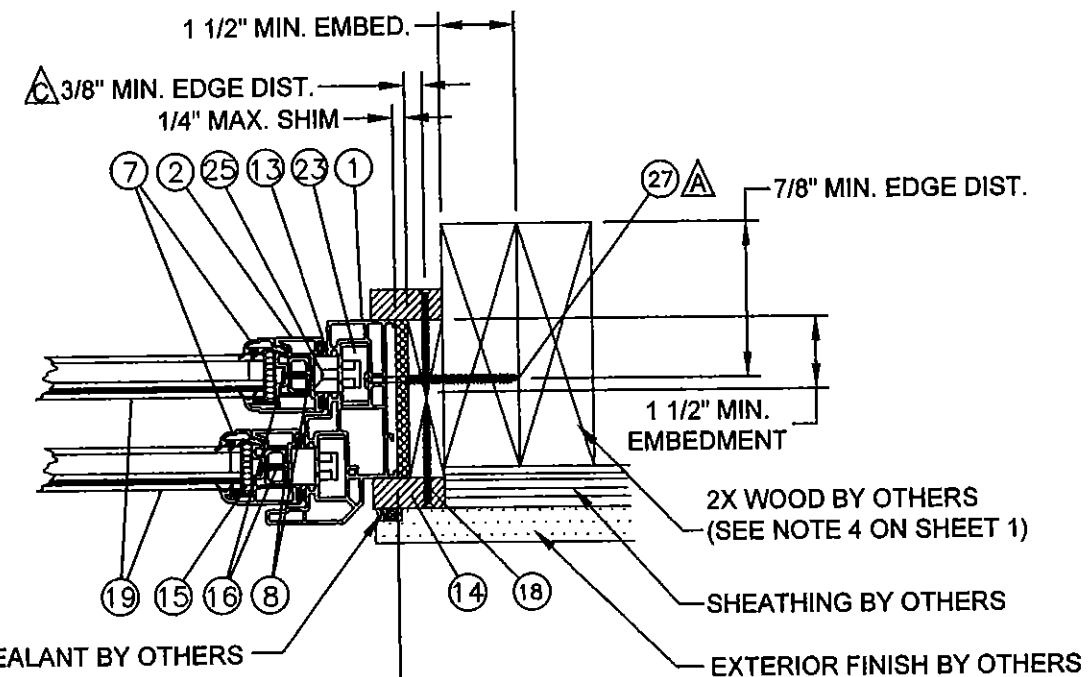

K HORIZONTAL SECTION
WOOD FRAME SUBSTRATE


PROJECT #414-0418

REGENCY PLUS
2000 LOCUST GAP HIGHWAY
MT. CARMEL, PA 17851

TITLE: SERIES 5305 TILT DOUBLE HUNG IMPACT VINYL WINDOW
HORIZONTAL SECTIONS





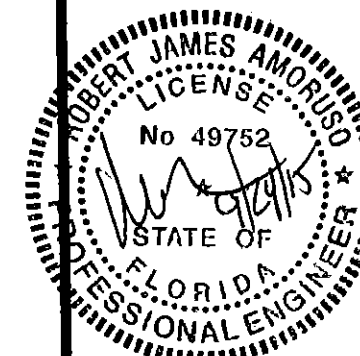











DRAWN BY: BB
SCALE: RPLS0064
REV: H
DATE: 1/12/09
DRAWING NO: RPLS0064
SHEET: 6 OF 8


Robert J. Amoroso, P.E.
Florida P.E. No. 49752




PRODUCT REVISED
as complying with the Florida
Building Code
Acceptance No 15-0618.02
Expiration Date May 6, 2019
By Manuel Perez
Miami/Dade Product Control

BILL OF MATERIALS


ITEM #	DESCRIPTION	MATERIAL	MANUFACTURER
1	MAIN FRAME	WHITE RIGID PVC	**RWDP 
2	SASH PANEL FRAME	WHITE RIGID PVC	**RWDP 
3	SASH COVER	WHITE RIGID PVC	**RWDP 
4	PANEL STOP / FRAME COVER	WHITE RIGID PVC	**RWDP 
5	SLOPED SILL COVER	WHITE RIGID PVC	**RWDP 
6	GLAZING STOP WITH HANDLE	WHITE RIGID PVC	**RWDP 
7	GLAZING STOP (OPERABLE SASH)	WHITE RIGID PVC	**RWDP 
8	REINFORCEMENT	STEEL	ROLL TECH INDUSTRIES
9	POCKET COVER #1	WHITE RIGID PVC	**RWDP 
10	BUG STRIP	VINYL	-----
11	INTERLOCK COVER	WHITE RIGID PVC	**RWDP 
12	WEEP COVER	NYLON	CUSTOM CRAFT
13	0.210" / 0.187" x 0.300" CENTER FIN WEATHERSTRIP	-----	ULTRAFAB
14	3/4" X 1 1/2" PARTING STOP (SEE NOTE 11A, SHT. 1) G= 0.55 MIN. 	PT PINE WOOD 	-----
15	SIKAFLEX 552 SILICONE	SILICONE	SIKA CORP.
16	#8 X 1/2" TEK SCREW	STEEL	-----
17	CAM TYPE SWEEP LOCK	STEEL	TRUTH HARDWARE
18	#8 WOOD SCREW (INSTALLATION ANCHOR)	STEEL	-----
19	7/8" O.A. INSULATED GLASS CONSISTING OF: 1/8" ANNEALED GLASS, 0.090" BUTACITE INTERLAYER BY KURARAY AMERICA, INC., 1/8" ANNEALED GLASS, 0.39" AIR SPACE, 1/8" TEMPERED GLASS 	GLASS	-----
20	BULB VINYL WEATHERSTRIP	VINYL	UNIVERSAL POLYMERE & RUBBER
21	FACE MOUNTED KEEPER	STEEL	TRUTH HARDWARE
22	SPRING BALANCE	-----	BSI HARDWARE
23	LOCKING TILT SHOE	NYLON	BSI BALANCE SYSTEMS
24	HURRICANE TILT LATCH (1057 EW) 	STEEL - ZINC CTD.	VISION INDUSTRIES
25	PIVOT BAR	METAL	VISION INDUSTRIES
26	SIKAFLEX 552 BACKBEDDING	SILICONE	SIKA CORP.
27	#12 WOOD SCREW (INSTALLATION ANCHOR)	STEEL	-----
28	1/4" ITW ADVANCED THREADFORM TAPCON 	STEEL	ITW
29	ENDUR 9.8 SS SPACER 	STAINLESS STL.	CARDINAL
30	GLAZING PAD (SETTING BLOCK 2NB-8K-125-028-026) 	NEOPRENE	FRANK LOWE

 ** RWDP: ROYAL WINDOWS AND DOOR PROFILES, PLANT NO. 13 MD NOA NO. 12-1120.02.


17 SASH LOCK
STEEL
TYP. WALL THICKNESS NA

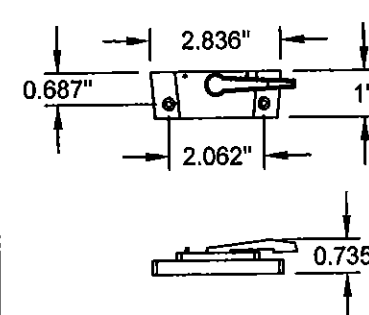


23 LOCKING TILT SHOE
NYLON
TYP. WALL THICKNESS NA

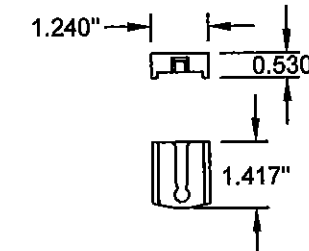


1 MAIN FRAME
WHITE RIGID PVC
TYP. WALL THICKNESS 0.070"

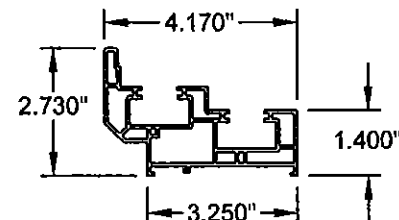


2 SASH PANEL FRAME
WHITE RIGID PVC
TYP. WALL THICKNESS 0.070"

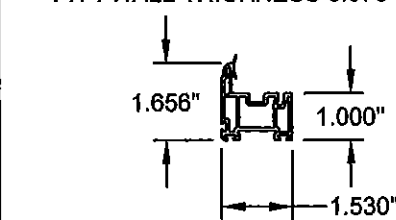


3 SASH COVER
WHITE RIGID PVC
TYP. WALL THICKNESS 0.065"

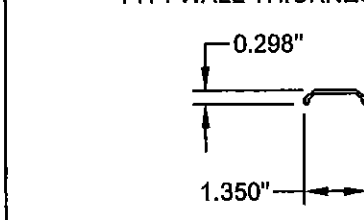


PANEL STOP / FRAME COVER
4 WHITE RIGID PVC
TYP. WALL THICKNESS 0.070"

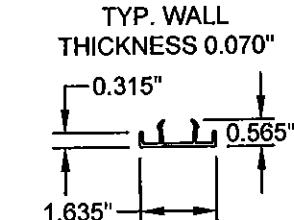


21 FACE MOUNTED KEEPER
STEEL
TYP. WALL THICKNESS 0.070"

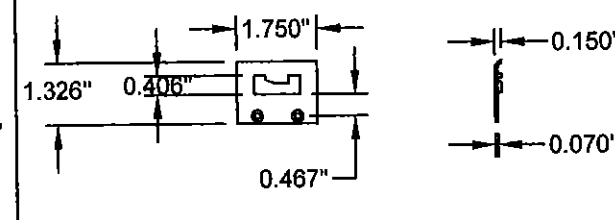


5 SLOPED SILL COVER
WHITE RIGID PVC
TYP. WALL THICKNESS 0.075"

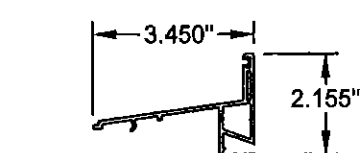


GLAZING STOP / LIFT HANDLE
6 WHITE RIGID PVC
TYP. WALL THICKNESS 0.055"

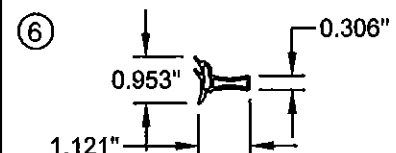


7 GLAZING STOP (OPERABLE SASH)
WHITE RIGID PVC
TYP. WALL THICKNESS 0.055"

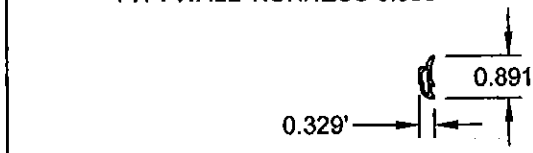

9 POCKET COVER
WHITE RIGID PVC
TYP. WALL THICKNESS 0.070"

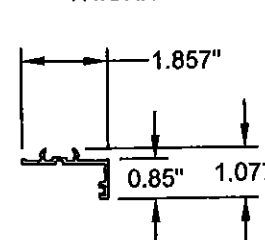


22 SPRING BALANCE

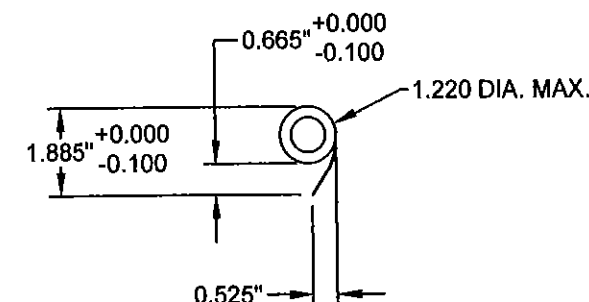


8 REINFORCEMENT
STEEL
TYP. WALL THICKNESS 0.062"

11 INTERLOCK COVER
WHITE RIGID PVC
TYP. WALL THICKNESS 0.075"

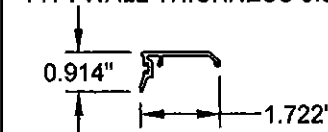

14 PARTING STOP
WOOD

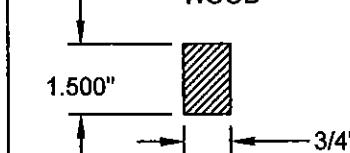


PROJECT #414-0418

REGENCY PLUS
2000 LOCUST GAP HIGHWAY
MT. CARMEL, PA 17851

TITLE: SERIES 5305 TILT DOUBLE HUNG IMPACT VINYL WINDOW
BILL OF MATERIALS & COMPONENTS


DRAWN BY: BB
DATE: 1/12/09
SCALE: RPLS0064
SHEET: 7 OF 8
REV: H

Robert J. Amoroso, P.E.
Florida P.E. No. 49752


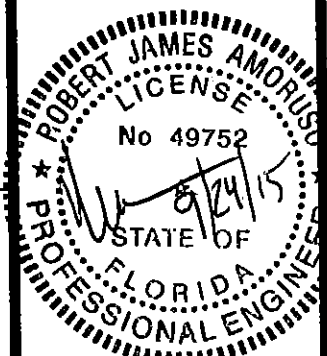


PRODUCT REVISED
as complying with the Florida
Building Code
Acceptance No. 15-0618.02
Expiration Date May 6, 2019
By: Manuel Perez
Miami Dade Product Control

②④ **TILT LATCH**
STEEL - ZINC COATED

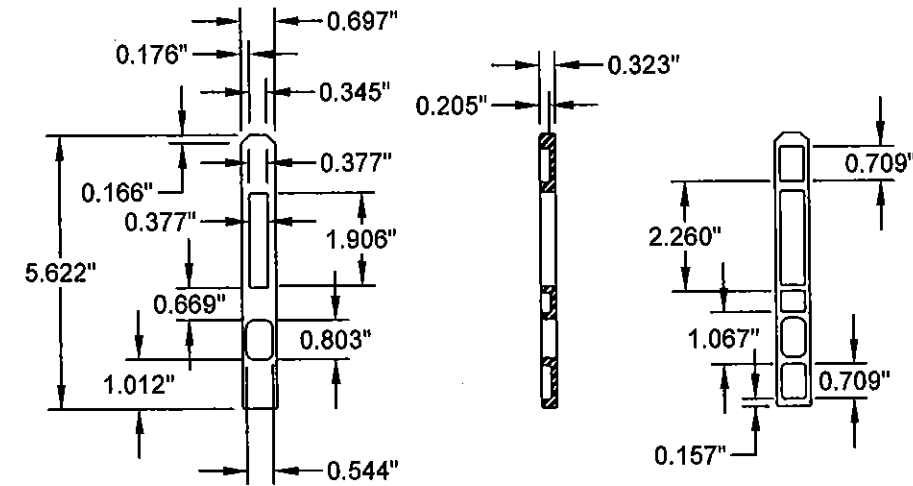

②⑤ **PIVOT BAR**
METALTYP. WALL THICKNESS NA

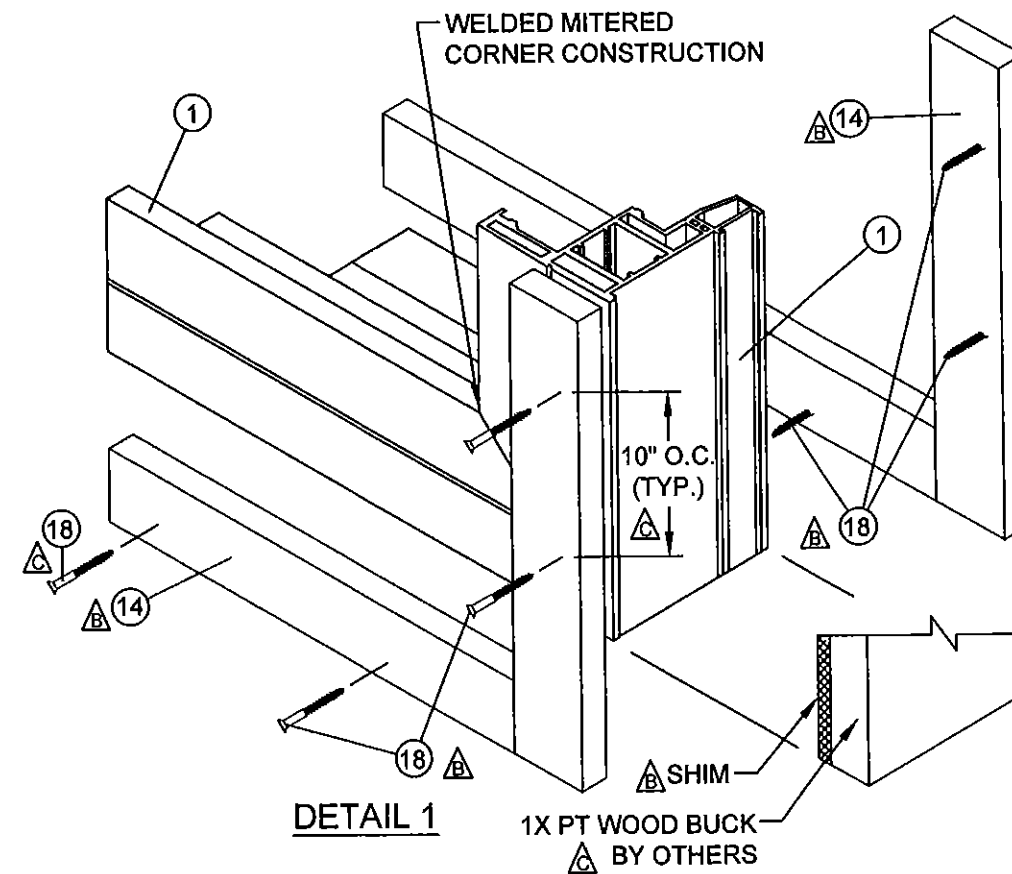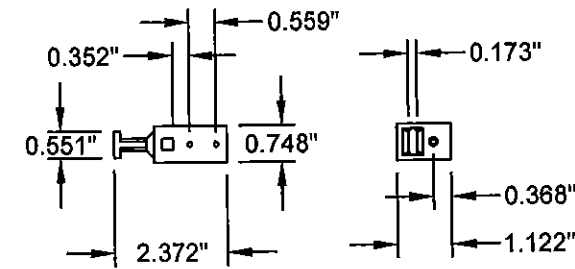

DETAIL 1

NOTE:
PARTING STOP EXTERIOR PERIMETER
TO BE SEALED TO 1X PT WOOD BUCK
WITH SIKA 551 SILICONE

PROJECT #414-0418


REV	DATE	DESCRIPTION
H	9/24/15	INCORPORATE M.D. RFI COMMENTS
G	9/1/15	INCORPORATE M.D. RFI COMMENTS
F	6/1/15	UPDATED TO 5TH ED. (2014) FBC
BY		

REGENCY PLUS
2000 LOCUST GAP HIGHWAY
MT. CARMEL, PA 17851
TITLE: SERIES 5305 TILT DOUBLE HUNG IMPACT VINYL WINDOW
COMPONENTS & CORNER DETAIL

DATE:	1/12/09
DRAWING NO:	RPLS0064
SCALE:	
REV:	H
SHEET:	8 OF 8

PTC
PTC Product Design Group, LLC
PO Box 520775, Longwood, FL 32752-0775
321-590-1788 info@ptc-corp.com
FBPE Cert. of Auth. No. 25935

Robert J. Amoruso, P.E.
Florida P.E. No. 49752

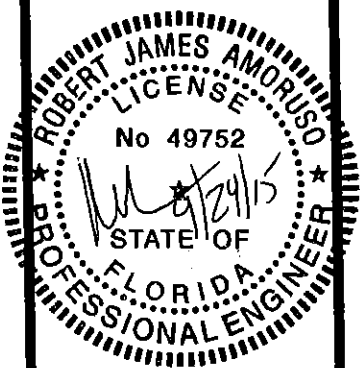

PRODUCT REVISED
as complying with the Florida
Building Code
Acceptance No. 15-0618.02
Expiration Date May 6, 2019
By *Manuel Fire*
Miami Dade Product Control